COAST GUARD
627
VIGOROUS
SOUTH PIER

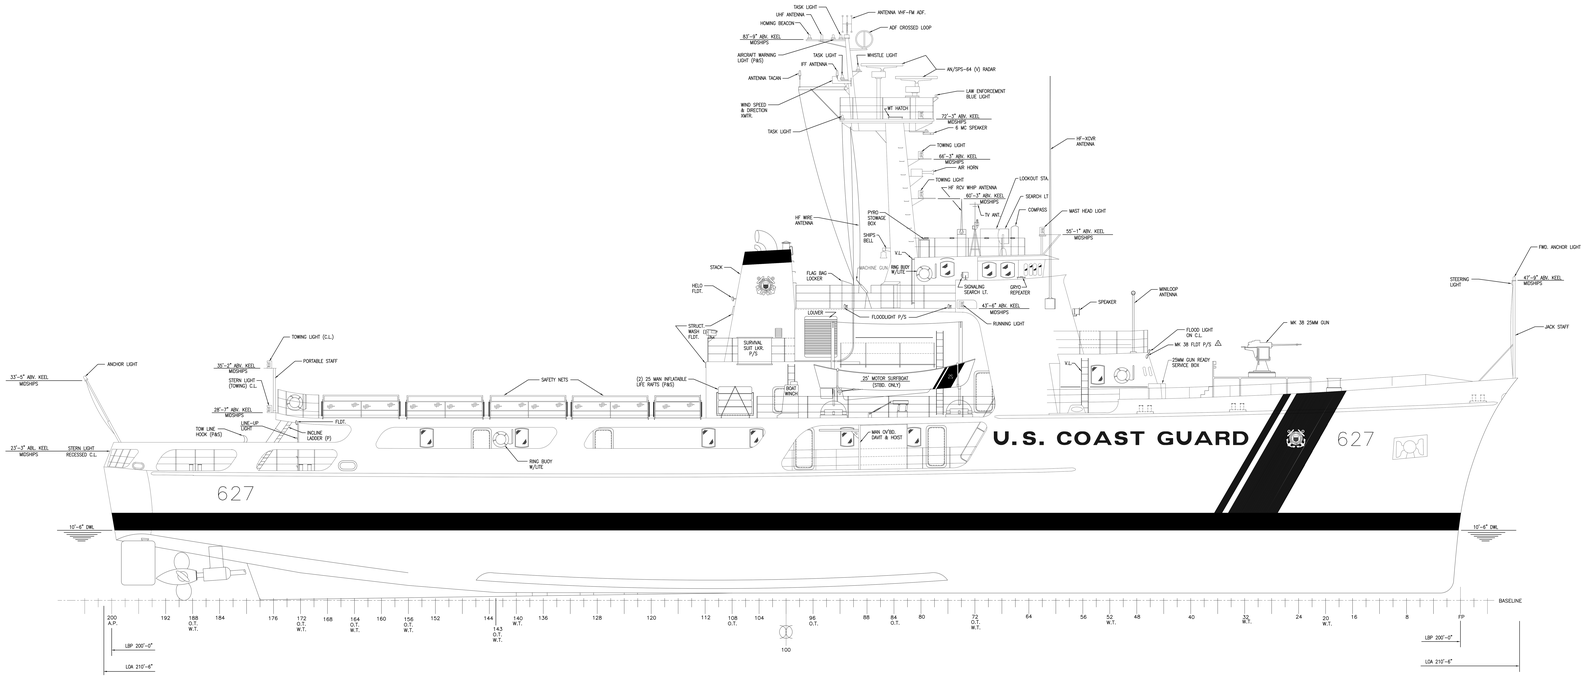

REVISIONS							
REV	SHT	ZONE	DESCRIPTION	BY	DATE	APRVD	
A	1		1. UPDATED DRAWING TO REFLECT AS BUILT.	TJO	1-25-93	RVS /SJ/	
B	1	ALL	ADDED APPLICABILITY AND UPDATED TITLE BLOCK WM 210 PARENT SERIES.	LJ	8-25-99	TGB	
C		B-3	RELOCATED MK-38 RED FLOOD LIGHT FROM HAND RAIL TO 02 DECK LEVEL.	MLS	8-25-10	KT / CC	

GENERAL NOTES

1. THIS DRAWING WAS DEVELOPED IN ACCORDANCE WITH GUIDANCE SPECIFICATIONS FOR 210 CLASS WMEC MAJOR MAINTENANCE AVAILABILITY.

DISTRIBUTION STATEMENT D- DISTRIBUTION AUTHORIZED TO DHS/CG/000 AND THEIR CONTRACTORS; ADMINISTRATIVE AND OPERATIONAL PURPOSE; 01/01/2005. OTHER REQUESTS SHALL BE REFERRED TO COMMANDING OFFICER, USCG SFLC ESD TWB, 2401 HAWKINS POINT ROAD, MAIL STOP 25/TONYO PROJECT MANAGER, BALTIMORE, MD 21226-5000.
WARNING-THIS DOCUMENT CONTAINS TECHNICAL DATA WHOSE EXPORT IS RESTRICTED BY THE ARMS EXPORT CONTROL ACT (TITLE 22, U.S.C. 2751 ET SEQ.) OR THE EXPORT ADMINISTRATION ACT OF 1979, AS AMENDED, TITLE 50, U.S.C. APP. 2401 ET. SEQ. VIOLATIONS OF THESE EXPORT LAWS ARE SUBJECT TO SEVERE CRIMINAL PENALTIES.
DESTRUCTION NOTICE-FOR UNCLASSIFIED, LIMITED DOCUMENTS, DESTROY BY ANY METHOD THAT WILL PREVENT DISCLOSURE OF CONTENTS OR RECONSTRUCTION OF THE DOCUMENT.

PLAN DISTRIBUTION	
ENGINEERING DEPT.	
OPERATIONAL SHOPS:	
CHEMICAL SHOPS:	
CLERICAL SHOPS:	
PAINTERS SHOPS:	
SHIPS OFFICE	

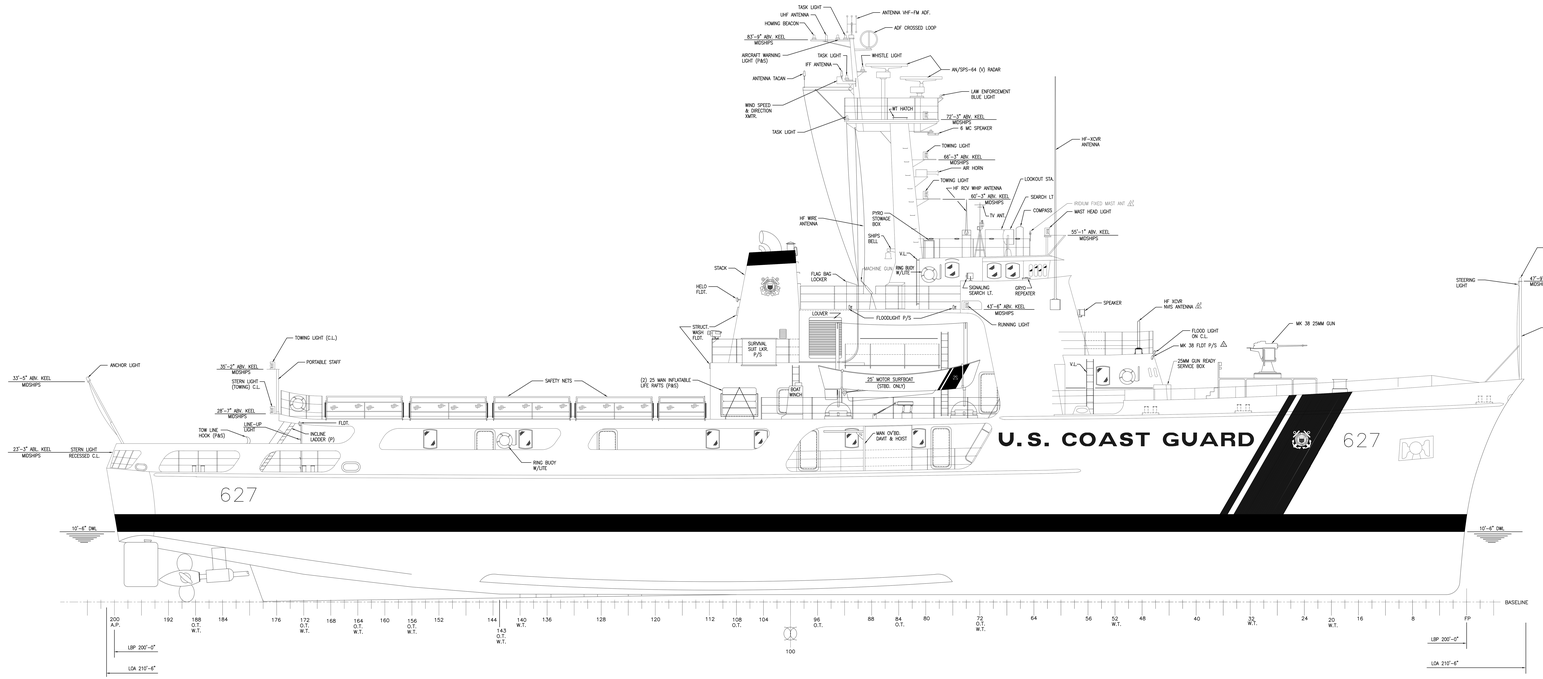

DWG NO	SH	REV
62/7WMEC-601-001	1	E

REV	SHT	ZONE	REVISIONS DESCRIPTION	BY	DATE	APRVD
A	1		1. UPDATED DRAWING TO REFLECT AS BUILT.	TJO	1-25-93	RVS /S/
B	1	A-L	1. ADDED APPLICABILITY AND UPDATED TITLE BLOCK WW 210 PARENT SERIES.	LJC	9-25-99	TOB
C		B-D	RELOCATED MK-38 RED FLOOD LIGHT FROM YARD RAIL TO 02 DECK LEVEL.	MLS	8-25-10	KT / CC
D	1 1	2-A 7-E	THIS REVISION INCORPORATES UPDATES PERFORMED UNDER THE HF LIFECYCLE REPLACEMENT PROGRAM. 1. REVISED APPLICABILITY. 2. REMOVED WM4 LOOP ANTENNA. ADDED NVIS ANTENNA.	PJM-ATC	8-19-11	MGT /S/ CSCEN
E	1 1	2-A 8-F	THIS REVISION INCORPORATES THE INSTALLATION OF THE IRIDIUM SATELLITE PHONE SYSTEM. 1. REVISED APPLICABILITY. 2. ADDED IRIDIUM FIXED MAST ANTENNA.	PJM-ATC	11-3-11	MGT /S/ CSCEN

GENERAL NOTES

1. THIS DRAWING WAS DEVELOPED IN ACCORDANCE WITH GUIDANCE SPECIFICATIONS FOR 210 CLASS WMEC MAJOR MAINTENANCE AVAILABILITY.

DISTRIBUTION STATEMENT D:- DISTRIBUTION AUTHORIZED TO DHS/CG/DOD AND THEIR CONTRACTORS; ADMINISTRATIVE AND OPERATIONAL PURPOSE; 01JUL2009. OTHER REQUESTS SHALL BE REFERRED TO: COMMANDING OFFICER, USCG SFLC ESD TMB, 2401 HAWKINS POINT ROAD, MAIL STOP 25,TOTINO PROJECT MANAGER, BALTIMORE, MD 21226-5000.
WARNING:-THIS DOCUMENT CONTAINS TECHNICAL DATA WHOSE EXPORT IS RESTRICTED BY THE ARMS EXPORT CONTROL ACT TITLE 22, U.S.C. SEC. 2751, ET. SEQ. OR THE EXPORT ADMINISTRATION ACT OF 1979, AS AMENDED, TITLE 50, U.S.C., APP. 2401 ET SEQ. VIOLATIONS OF THESE EXPORT LAWS ARE SUBJECT TO SEVERE CRIMINAL PENALTIES.
DESTRUCTION NOTICE-FOR UNCLASSIFIED, LIMITED DOCUMENTS, DESTROY BY ANY METHOD THAT WILL PREVENT DISCLOSURE OF CONTENTS OR RECONSTRUCTION OF THE DOCUMENT.

630	ALERT	E	
629	DEDISAE	E	
627	VIGOROUS	E	
626	DEFENDABLE	E	
625	VENERABLE	E	
624	DAUNTLESS	E	
623	STEADFAST	E	
621	VALIANT	E	
620	RESOLUTE	E	
HULL NO.	VESSEL NAME	PEQ	
APPLICABILITY		LIST	

* 210'S SERIES DRAWING NUMBER WAS 62/WMEC-0100-3

USCG SMEL CARYS SHY BALTIMORE, MARYLAND 21226		
	INITIALS	DATE
DESIGN		
DRAWN	MRA	
CHECKED	MLS	
R.J. Fredericks		04/19/93
CHIEF HULL BRANCH		
U.S.C.G. APPROVAL		1-12-93
R.J. Fred. Fredericks		
CHIEF ENGINEERING DIVISION		

U.S. COAST GUARD HEADQUARTERS WASHINGTON, D.C. 20593
OFFICE OF NAVAL ENGINEERING
210' MMA "B" CLASS
OUTBOARD PROFILE

SIZE	FICHE CAGE NO	U.S.C.G. DRAWING NO.	REV
H	81340	62/WMEC-601-001	E

SCALE 1/4"=1'-0" 19.6 SQ. FT. SHEET 1 OF 1

PLAN DISTRIBUTION	LOCAL CENTER	CENTER
ENGINEERING	1	1
STRUCTURAL DESIGN	1	1
A-1	1	1
A-2	1	1
A-3	1	1
MECHANICAL DESIGN	1	1
M-1	1	1
M-2	1	1
ELECTRICAL DESIGN	1	1
E-1	1	1
E-2	1	1
HULL DESIGN	1	1
H-1	1	1
H-2	1	1
H-3	1	1
H-4	1	1
H-5	1	1

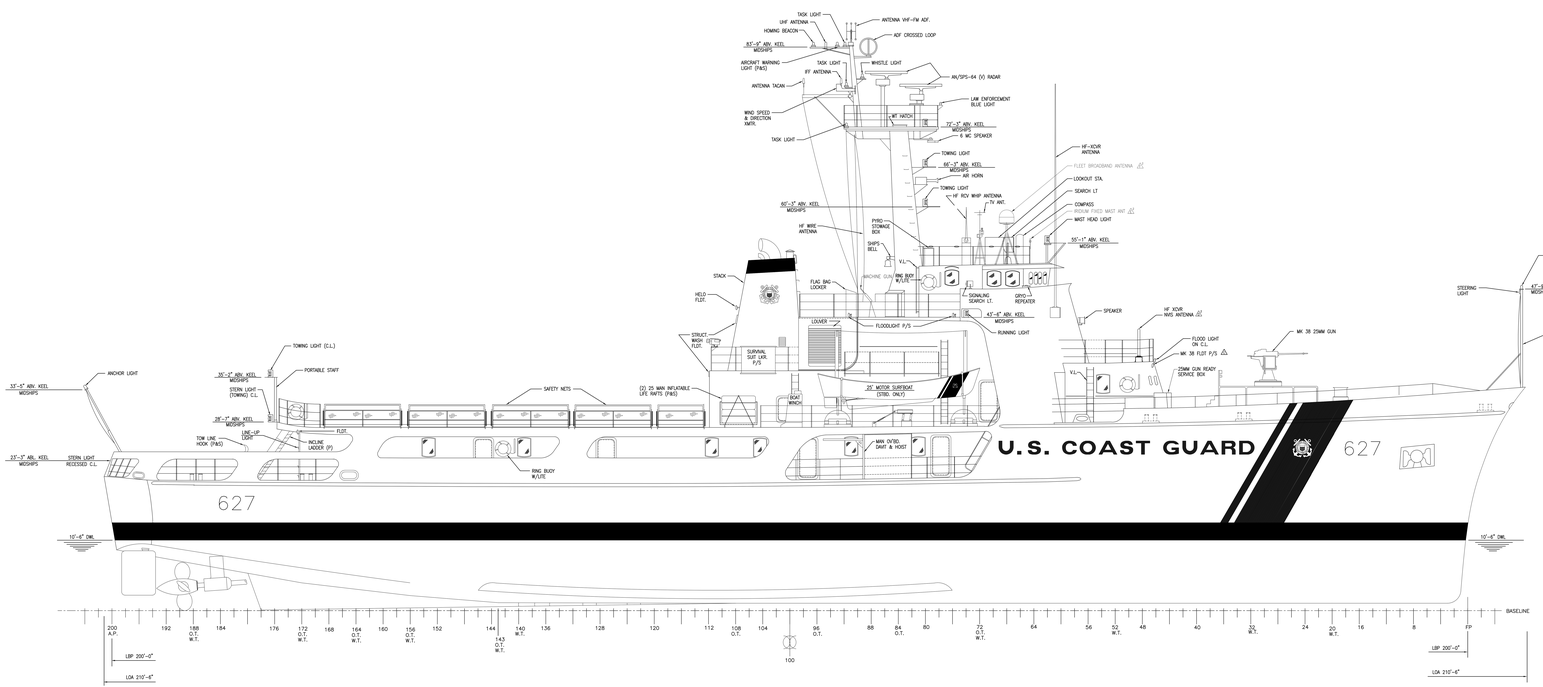

REV	SHT	ZONE	REVISIONS DESCRIPTION	BY	DATE	APRVD
A	1		1. UPDATED DRAWING TO REFLECT AS BUILT.	TJO	1-25-93	RVS /S/
B	1	ALL	1. ADDED APPLICABILITY AND UPDATED TITLE BLOCK AM 210 PARENT SERIES.	TJO	9-25-99	TCB
C		B-D	RELOCATED MK-38 RED FLOOD LIGHT FROM HAND RAIL TO 02 DECK LEVEL.	WLS	8-25-10	KT / CC
D	1 1	2-A 7-C	THIS REVISION INCORPORATES UPDATES PERFORMED UNDER THE HF LIFECYCLE REPLACEMENT PROGRAM: 1. REVISED APPLICABILITY. 2. REMOVED WIM LOOP ANTENNA. ADDED MARS ANTENNA.	PJW/ KTG	8-19-11	MOT /V/ CCKEN
E	1 1	2-A B-F	THIS REVISION INCORPORATES THE INSTALLATION OF THE INVOUR SATELLITE PHONE SYSTEM: 1. REVISED APPLICABILITY. 2. ADDED INVOUR FIXED MAST ANTENNA.	PJW/ KTG	11-3-11	MOT /V/ CCKEN
F	1 1	2-A B-C	THIS REVISION INCORPORATES THE INSTALLATION OF THE FLEET BROADBAND SYSTEM: 1. REVISED APPLICABILITY. 2. ADDED FLEET BROADBAND ANTENNA.	WLS/ KTG	5/29/13	TJB/V/ CCKEN

GENERAL NOTES

1. THIS DRAWING WAS DEVELOPED IN ACCORDANCE WITH GUIDANCE SPECIFICATIONS FOR 210 CLASS WMEC MAJOR MAINTENANCE AVAILABILITY.

DISTRIBUTION STATEMENT D:- DISTRIBUTION AUTHORIZED TO DHS/CG/DOD AND THEIR CONTRACTORS; ADMINISTRATIVE AND OPERATIONAL PURPOSES; 05/01/2008. OTHER REQUESTS SHALL BE REFERRED TO: COMMANDING OFFICER, USCG SFLC, ESD TMG, 2421 HAWKINS POINT ROAD, MML STOP 2512(TMG) PROJECT MANAGER, BALTIMORE, MD 21226-5000.
WARNING-THIS DOCUMENT CONTAINS TECHNICAL DATA WHOSE EXPORT IS RESTRICTED BY THE ARMS EXPORT-CONTROL ACT (TITLE 22, U.S.C. SEC 2751, ET SEQ.) OR THE EXPORT ADMINISTRATION ACT OF 1979, AS AMENDED, TITLE 50, U.S.C. APP. 2401 ET SEQ. VIOLATORS OF THESE EXPORT LAWS ARE SUBJECT TO SEVERE CRIMINAL PENALTIES. DISCLOSURE TO FOREIGN NATIONALS, LIMITED DOCUMENTS, DESTROY BY ANY METHOD THAT WILL PREVENT DISCLOSURE OF CONTENTS OR RECONSTRUCTION OF THE DOCUMENT.

9000 SERIES DRAWING NUMBER WAS 627WMEC-0555-3

USCG TMD, CURTIS BAY BALTIMORE, MARYLAND 21226	INITIALS	DATE
DESIGN		
DRAWN	MHH	
CHECKED	WLS	
P.E. (Name) (Title)		
CHIEF FULL DRAWER		

U.S. COAST GUARD HEADQUARTERS WASHINGTON, D.C. 20593

OFFICE OF NAVAL ENGINEERING

210' MMA WMEC

OUTBOARD PROFILE

630	ALERT	
629	DEDSHA	
627	HUDRAGUE	
626	DEPENDABLE	
625	VENTAROUX	
624	DAUNTLESS	
623	STEADFAST	
621	VALIANT	
620	RESOLUTE	
HULL NO.1 VESSEL NAME	REV	

APPLICABILITY LIST

U.S.C.G. APPROVAL
R.E. Fain, Captain
CHIEF ENGINEERING DIVISION

SIZE	FSCM CAGE NO.	U.S.C.G. DRAWING NO.	REV
H	81340	627WMEC-601-001	F

SCALE: VARVT-0" TRIM TO FT SHEET 1 OF 1

DWG NO. 627WMEC-601-001 SH 1 REV F

PLAN DISTRIBUTION	ABOVE DEPLOYED	AFLOAT
ENGINEERING DEPT		
OPERATIONAL DEPTS.		
A		
B		
C		
GENERAL DEPTS.		
D		
E		
F		
GENERAL DEPTS.		
G		
H		
SERVICE DEPTS.		
I		
J		
K		
L		
TOTAL SUM		
PLANS		
ELECTRIC		
HULL & M		
PLANS - TYPE C - ORIGINAL		
ELECTRIC		
HULL & M		
PLANS - TYPE D		
ELECTRIC		
HULL & M		
TOTAL PLANS DEL. AFLOAT/ABOVE		
ELECTRONIC		
ELECTRICAL		
HULL & M		
TOTAL		

627WMEC-601-001 | F

DWG NO. 627WMEC-601-001 SH 1 REV F

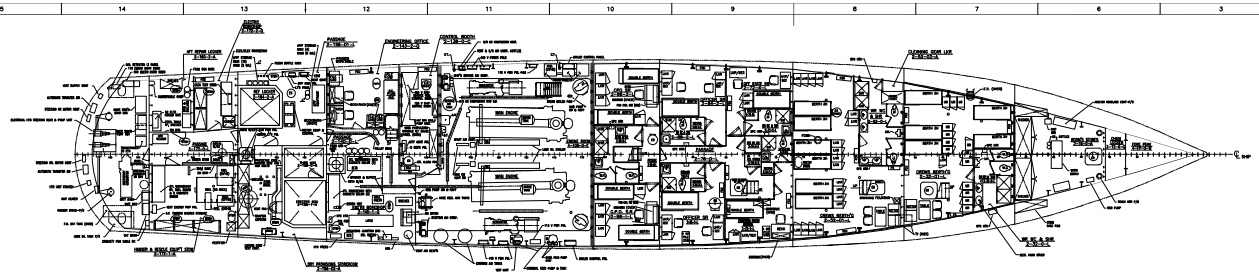

SECOND DECK

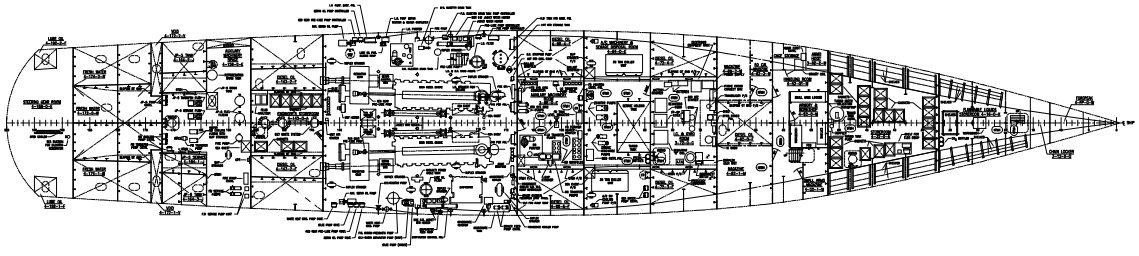

THIRD DECK

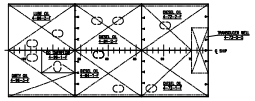

TANKS BELOW THIRD DECK



REVISIONS

REV	SHT	ZONE	DESCRIPTION	BY	DATE	APPRO
A	1		1. REVISED STATUS BOARD SHEET 2-20-1 TO SHEET 2-20-2 AND ADDED NEW SHEET 2-20-1 ADDED NEW 2-20-3 AND 2-20-4 ADDED 2-2-2 & 2-2-3 ADDED 1-10-1 TO 1-10-7 2. ADDED GENERAL NOTE NO. 4 TO 2-0-0 & 1-0-0	RBB	6-17-91	MS/LV
B	1	ALL	1. UPDATED DRAWING TO REFLECT AS BUILT.	SJD	1-30-92	MS/LV
C	1	ALL	1. ADDED APPLICABILITY AND UPDATED TITLE BLOCK FOR 210 FOOT MARKER.	TJD	9-30-92	TJD
D			THIS REVISION INCORPORATES THE NEW LAYOUT REFLECTED IN DWG 82WEC-210-10-SCHLE			
	1	2-4	1. ADDED APPLICABILITY LIST.	MC	9-27-12	MS/LV/ TJD/JW
	1	8-9	2. REMOVED UPS.			
	1	8-9	3. ADDED FOUNDATION, ADDED DISCONNECT SWITCH.			
E			THIS REVISION IS IN ACCORDANCE WITH THE 2012 REPORT 2 SHIP ALTERATION "BOARD DWG 210 WMEC ATT BACK, 82WEC-210-11-01".	CJD/ DHD	11/05/14	MS/LV/DHD/ JW/ CJD/ DHD/ JW/
	1	13-14	1. ADDED TWO STORAGE RACK (1X) CONE 8 ONLY TO THE CENTRAL ATT STORAGE RACK.			
	1	13-14	2. ADDED TWO STORAGE RACK (X) CONE 8 ONLY.			
			3. CHANGE / & MOVEMENT			

GENERAL NOTES

1) THIS DRAWING WAS DEVELOPED IN ACCORDANCE WITH CURRENT SPECIFICATION FOR 210 CLASS WMEC MAIN MAINTENANCE ANCHORLIFT.

1	JONES ANNEX 2ND DC	82WMEC-601-001
2	SEATING AND INSULATION	82WMEC-601-002
3	ROC STATION	82WMEC-601-004
4	ANNEX LADDER	82WMEC-601-005
5	ANNEX LADDER	82WMEC-601-006
6	ANNEX STORAGE	82WMEC-601-007
7	SCHEDULE OF ACCESS DOORS, CARGOES, MANHOLES, & ETC	82WMEC-601-008

NO. TITLE PLAN NO.

REFERENCE PLAN

* DOCO SERIES DRAWING NUMBER NOW 82WMEC-2003-3


APPLICABILITY LIST

U.S. COAST GUARD HEADQUARTERS WASHINGTON, D.C. 20590

OFFICE OF NAVAL ENGINEERING

210' WMA "U" CLASS

GENERAL ARRANGEMENT– SECOND AND THIRD DECKS

SIZE H	CODE IDENT NO. 81340	DRAWING NO. 82WMEC-601-003	REV E
SCALE 1/4" = 1'-0"		SHEET 1 OF 1	

PLAN DISTRIBUTION

DOD	
DOD	
DOD	

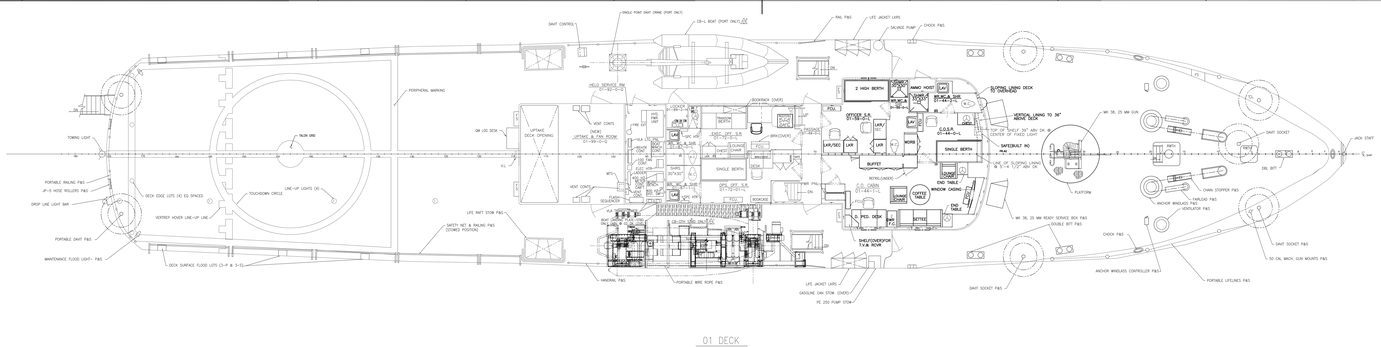
01 DECK
2 HIGH BERTH
SINGLE BERTH
END TABLE
WINDOW CASING
COFFED TABLE
BUFFET
SAFEGUARD RO
SHELVES/DESKTOP 1'-0 W. ROUND
PED. DESK
SWITCH NET & RAILING PAS (STOWED POSITION)
LIFE RAFT STOW PAS
PORTABLE WIRE ROPE PAS
LIFE JACKET LKRS
GASOLINE CAN STOW (SHADED)
FC 250 PUMP STOW
SHAFT SOCKET PAS
PORTABLE LIFELINES PAS
50 CAL MACH. GUN MOUNTS PAS
ANCHOR WINDLASS CONTROLLER PAS
ANCHOR WINDLASS PAS
VENTILATOR PAS
CHAIN STOPPER PAS
CHOCK PAS
SHAFT SOCKET
BITT
JACK STAFF
PLATFORM
WM 38, 25 MW GUN
WM 38, 25 MW READY SERVICE BOX PAS
DOUBLE BITT PAS
VERTICAL LIFING TO 36" ABOVE DECK
TOP OF TWILIGHT 36" ABV DK
CENTER OF FIXED LIGHT
TOP OF FLOODING LIGHT
36" X 4 1/2" ABV DK
SINGLE BERTH
LOUNGE CHAIR
END TABLE
FIXED LIGHT
FIXED LIGHT
FIXED LIGHT

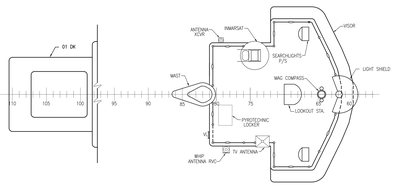

PILOT HOUSE TOP

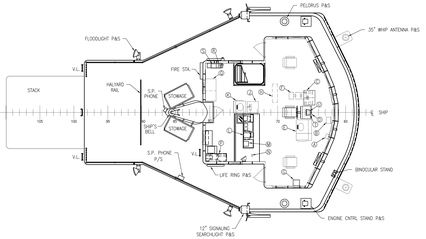

BRIDGE DECK

PILOT HOUSE 03-62-0-C

1. RUDDER ANGLE INDICATOR
2. DEPTH FINDER INDICATOR (2118/SQN-18)
3. ENGINE CONTROL STAND
4. DUAL STEERING STAND
5. NAVCAS V COLLISION AVOIDANCE SYSTEM, RADAR IND.
6. ANEMOMETER, WIND SPEED
7. INTERCOMM CTL, CAT 2INC, LS-514/SIC
8. LIGHTING DISTRIBUTION PANEL, (03-74-2)
9. LOG DESK
10. INDICATOR, RADAR, IP-1282/SPS-64(V)
11. RADIO, ANTENNA ROTATION RDC-24, "MD-HC"
12. DEPTH INDICATOR & ALARM CEUC-9-999
13. CHART TABLE
14. COMPUTER TERMINAL
15. CABINET, ACO WORK DESK/OM STOWAGE
16. TACHOMETER DEPTH SOUNDER CEUC-R-8220
17. CHART RECORDER

PILOT HOUSE (CONTINUED)

18. GYRO STEERING REPEATER
19. PERISCOPE UNIT FOR MAG. COMPASS

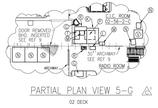

PARTIAL PLAN VIEW 5-G △5

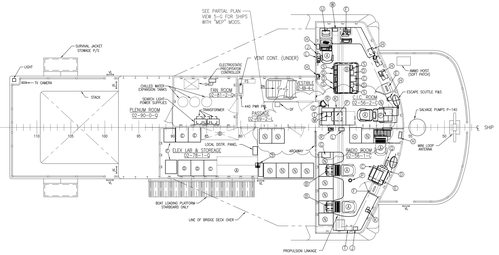

02 DECK △4,5

C.I.C. 02-56-2-C

1. RADIO OPERATOR CHAIR
2. CHART TABLE
3. STATION, CONTROL, 21 MC, LS 518A/SIC
4. AMPLIFER/VF, MODEL AM-3729/SR
5. PAPER SHREDDER
6. FIRE EXTINGUISHER
7. REPEATER, GYRO COMPASS
8. LOUDSPEAKER, LS-474/U
9. SHELF PANEL, (02-68-2)
10. 5 DR FILE CABINET (SWIT)
11. FIRE EXTINGUISHER
12. INDICATOR/CONTROL UNIT, TACAN, CQ/-10-339F-12E
13. CABINET, ELECTRICAL, AN/USH-28(V)
14. INDICATOR, WIND SPEED, MODEL FREZ 135
15. 4 DR FILE CABINET
16. CONSOLE, SECRET RADIO
17. KCVR, TACAN
18. SCCS CONSOLE
19. SCCS OPERATOR POSITION
20. DOOR ENTRY ALARM PANELS

ELEX LAB & STORAGE 02-78-1-G

1. ELECTRONIC WORKBENCH
2. 2 DR SECURITY FILE
3. DRAWER STORAGE CABINET-SV-340
4. SHELF CABINET W/ DOORS-SV-50.55 (BN) (TOP)
   DRAWER STORAGE CABINET-SV-245 (BOTTOM)
5. SHELF CABINET W/ DOORS-SV-50.55 (LN) (TOP)
   DRAWER STORAGE CABINET-SV-245 (BOTTOM)
6. STORAGE SHELVES

RADIO ROOM 02-56-1-G

1. RADIO OPERATOR CHAIR
2. CHART TABLE (SWIT)
3. 2 DR SECURITY FILE CABINET (SWIT)
4. XEROX MACHINE
5. RECORDER/FACSIMILE, RAYFAX 1200, CRP-1200AHR
6. PAPER SHREDDER
7. CHARGER, BATTERY CHARGER/BATTERY: U/W FM PORTABLES
8. POWER PANEL (02-56-1)
9. AMPLIFER/VF, MODEL AM-3729/SR
10. JOVICON
11. POWER PANEL (02-64-1)
12. RACKS 1,2,3,4,5,6,7,8,9,10
13. RACKS 1,2,3,4,5,6,7,8,9,10, & 11
14. CLOCK
15. DETECTOR, FIRE & SMOKE, IONIZATION TYPE, SURF MTD, P/N DI-4A
16. FIRE EXTINGUISHER
17. RI-221, OPTIC IDUALROR, CQSW-R221
18. STATION, CONTROL, 21 MC, LS-518A/SIC

REV	SHT	ZONE	DESCRIPTION	BY	DATE	APRVD
A	1	ALL	1. UPDATED DRAWING TO REFLECT AS BUILT.	JJO	11-26-93	RVS /S/
B	1	ALL	1. ADDED APPLICABILITY AND UPDATED TITLE BLOCK AND 210 PARENT SERIES.	JJO	8-28-98	TGB /S/
C	1	5-D	1. PARTIAL PLAN VIEW 5-J ADDED FOR SHIPS WITH "MEP" MODS. ADDED 32" ARCHWAY TO AFT RADIO RM. REMOVED DOOR @ FR 71, & ADJUSTING BHD. TRACK "C" & SAFE "H" ARE MOVED TO NEW LOCATION WITH A PORTABLE CHAIR.	JJO	8-22-06	JPW /S/
		1-E	2. GENERAL NOTE #3 ADDED.			
		5-D	3. UPDATED 02 DECK PLAN TO SUIT LATEST ELECTRONICS ARRANGEMENT PLAN.	JGH		

GENERAL NOTES

1) THIS DRAWING WAS DEVELOPED IN ACCORDANCE WITH GUIDANCE SPECIFICATION FOR 210 CLASS WMEC MAJOR MAINTENANCE AVAILABILITY.
2) THE REMOVAL OF THE DOOR AT FR 71 & INSERTING 32" ARCHWAY IN THE CL BHD AT FR. 62.
3) THE REMOVAL OF THE DOOR AT FR 71 & INSERTING CL BHD IN CONJUNCTION WITH THE 210 "MEP" PROGRAM. (MISSION EFFECTIVE PROJECT

△2

10	PILOT HOUSE ARRANGEMENT	627WMEC-401-002
9	SUPERSTRUCTURE, AMI CASTLE, 01, 02 DK HOUSE, & STACK	627WMEC-152-001
8	ABREST OF ELEVT. (SUMP)-RADIO RM & DK	627WMEC-401-003
7	JOINER ABREST 01 DK & 02 DK	627WMEC-401-001
6	SHEATHING AND INSULATION	627WMEC-635-002
5	DECK COVERING	627WMEC-634-001
4	RECURVED LADDERS	627WMEC-623-001
3	VERTICAL LADDERS	627WMEC-623-001
2	JOINER DOOR SCHEDULE	627WMEC-624-001
1	SCHEDULE OF ACCESS DOORS, HATCHES, MANHOLES, & ETC	627WMEC-187-001
NO.	TITLE	PLAN NO.

REFERENCE PLAN

STINFO DESIGNATION

DISTRIBUTION STATEMENT D: DISTRIBUTION AUTHORIZED TO DHS/USCGOOS AND THEIR CONTRACTORS ONLY; DISTRIBUTION AUTHORIZED TO OTHER GOVERNMENT AGENCIES ONLY; OTHER REQUESTS SHALL BE REFERRED TO COMMANDING OFFICER, USCG SFLC 032 TMD, 2421 HABKINS POINT ROAD, MAIL STOP 25/STINFO PROJECT MANAGER, BALTIMORE, MD 21226-5000.
WARNING: THIS DOCUMENT CONTAINS TECHNICAL DATA WHOSE EXPORT IS RESTRICTED BY THE ARMS EXPORT-CONTROL ACT (TITLE 22, U.S.C. SEC 2751, ET. SEQ.) OR THE EXPORT ADMINISTRATION ACT OF 1979 (TITLE 50, U.S.C. SEC 2401 ET. SEQ.). VIOLATIONS OF THESE EXPORT LAWS ARE SUBJECT TO SEVERE CRIMINAL PENALTIES.
DISTRIBUTION NOTICE: FOR UNCLASSIFIED, LIMITED DOCUMENTS. DESTROY BY ANY METHOD THAT WILL PREVENT DISCLOSURE OF CONTENTS OR RECONSTRUCTION OF THE DOCUMENT.

* 9000 SERIES DRAWING NUMBER WAS 627WMEC-0103-5

A30	ALERT	A
A29	DESSIVE	B
A27	VIGOROUS	C
A26	DEPENDABLE	D
A25	VENTUROUS	E
A24	DAUNTLESS	F
A23	STEADFAST	G
A21	VALIANT	H
A20	RESOLUTE	J
HULL NO.	VESSEL NAME	PCO

APPLICABILITY LIST

USCG WMEC CUTTER RP
BALTIMORE, MARYLAND 21226

	INITIALS	DATE
DESIGN		
DRAWN	MPH	
CHECKED	WLS	

R.E. Grabowski 10/7/93
CHIEF, HULL BRANCH

USCG APPROVAL
R.E. Grabowski
CHIEF, ENGINEERING DIV.

U.S. COAST GUARD HEADQUARTERS WASHINGTON, D.C. 20593
OFFICE OF NAVAL ENGINEERING

210' MMA
"B" CLASS
GENERAL ARRANGEMENT–
02 DK, BRIDGE DK, &
HOUSE TOP

SIZE	FSCM CODE NO.	CLASS DRAWING NO.	REV
H	81340	627WMEC-601-005	C

SCALE 1/4" = 1'-0" 114.50 FT SHEET 1 OF 1

DWG NO 627WMEC-601-005 SH 1 REV C

PLOT SCALE: 1=48 FILE CODE: 627-WMEC_601_5_1_-_C.dwg

PLAN DISTRIBUTION

	CODE	PRINTS
CHIEF, HULL BRANCH		
CHIEF, ENGINEERING DIV.		
CHIEF, ELECTRICAL BRANCH		
CHIEF, ENGINEERING DIV.		
CHIEF, MECHANICA